

## DO NOT SCALE FROM THIS DRAWING

The contractor shall check and verify all dimensions on site and report any discrepancies in writing to Sheppard Robson before proceeding with work.

## FOR ELECTRONIC DATA ISSUE

Electronic data / drawings are issued as "read only" and should not be interrogated for measurement. All dimensions and levels should be read, only from those values stated in text, on the drawing.


## AREA MEASUREMENT

The areas are approximate and can only be verified by a detailed dimensional survey of the completed building. Any decisions to be made on the basis of these predictions whether as to project viability, pre-letting, lease agreements or the like, should include due allowance for the increases and decreases inherent in the design development and building processes. Figures relate to the likely areas of the building at the current state of the design and using the Gross External Area (GEA) / Gross Internal Area (GIA) / Net Internal Area (NIA) method of measurement from the Code of Measuring Practice, 8th Edition (RICS Code of Practice). All areas are subject to Town Planning and Conservation Area Consent, and detailed Rights to Light analysis.


## NOTES:

| REV | DATE     | AMENDMENT                                                                                                                                                                                            |
|-----|----------|------------------------------------------------------------------------------------------------------------------------------------------------------------------------------------------------------|
| C   | 04/04/12 | DRAWING STATUS REVISED TO 'AS BUILT'. STATUS LIMITED TO WHAT SR CAN ASCERTAIN WITHIN THE SCOPE OF ITS APPOINTED INSPECTION DUTIES. FREQUENCY OF INSPECTIONS AND NOTIFICATIONS OF CHANGE FROM OTHERS. |
| B   | 12/10/10 | CONSTRUCTION ISSUE                                                                                                                                                                                   |
| A   | 05/10/10 | SETTING OUT COORDINATES ADDED                                                                                                                                                                        |
| -   | 16/07/10 | SETTING OUT POINTS TO STRUCTURAL GRID REFER TO 4100-SK-092 FOR STRUCTURAL GRID                                                                                                                       |

## KEY PLAN

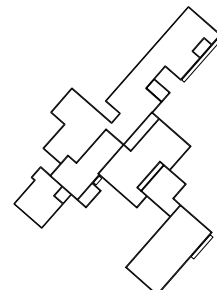

LOGO

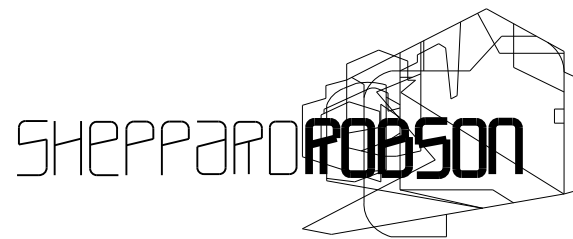

ARCHITECTURE URBAN DESIGN PLANNING INTERIORS

LOCATION 27th FLOOR, CITY TOWER, PICCADILLY PLAZA, MANCHESTER, M1 4BD  
PHONE +44 (0) 161 233 6900 FAX +44 (0) 161 233 6901  
WEBSITE www.sheppardrobson.com E-MAIL sr.mail@sheppardrobson.com

## DRAWING

Building Setting Out Points

SCALE @ A1 DATE 16.07.2010 ORIGINATOR SR CHECKED SC AUTHORISED SR

STATUS  
AS BUILT

DRAWING NO. 4100 - 00 - 122

C

